
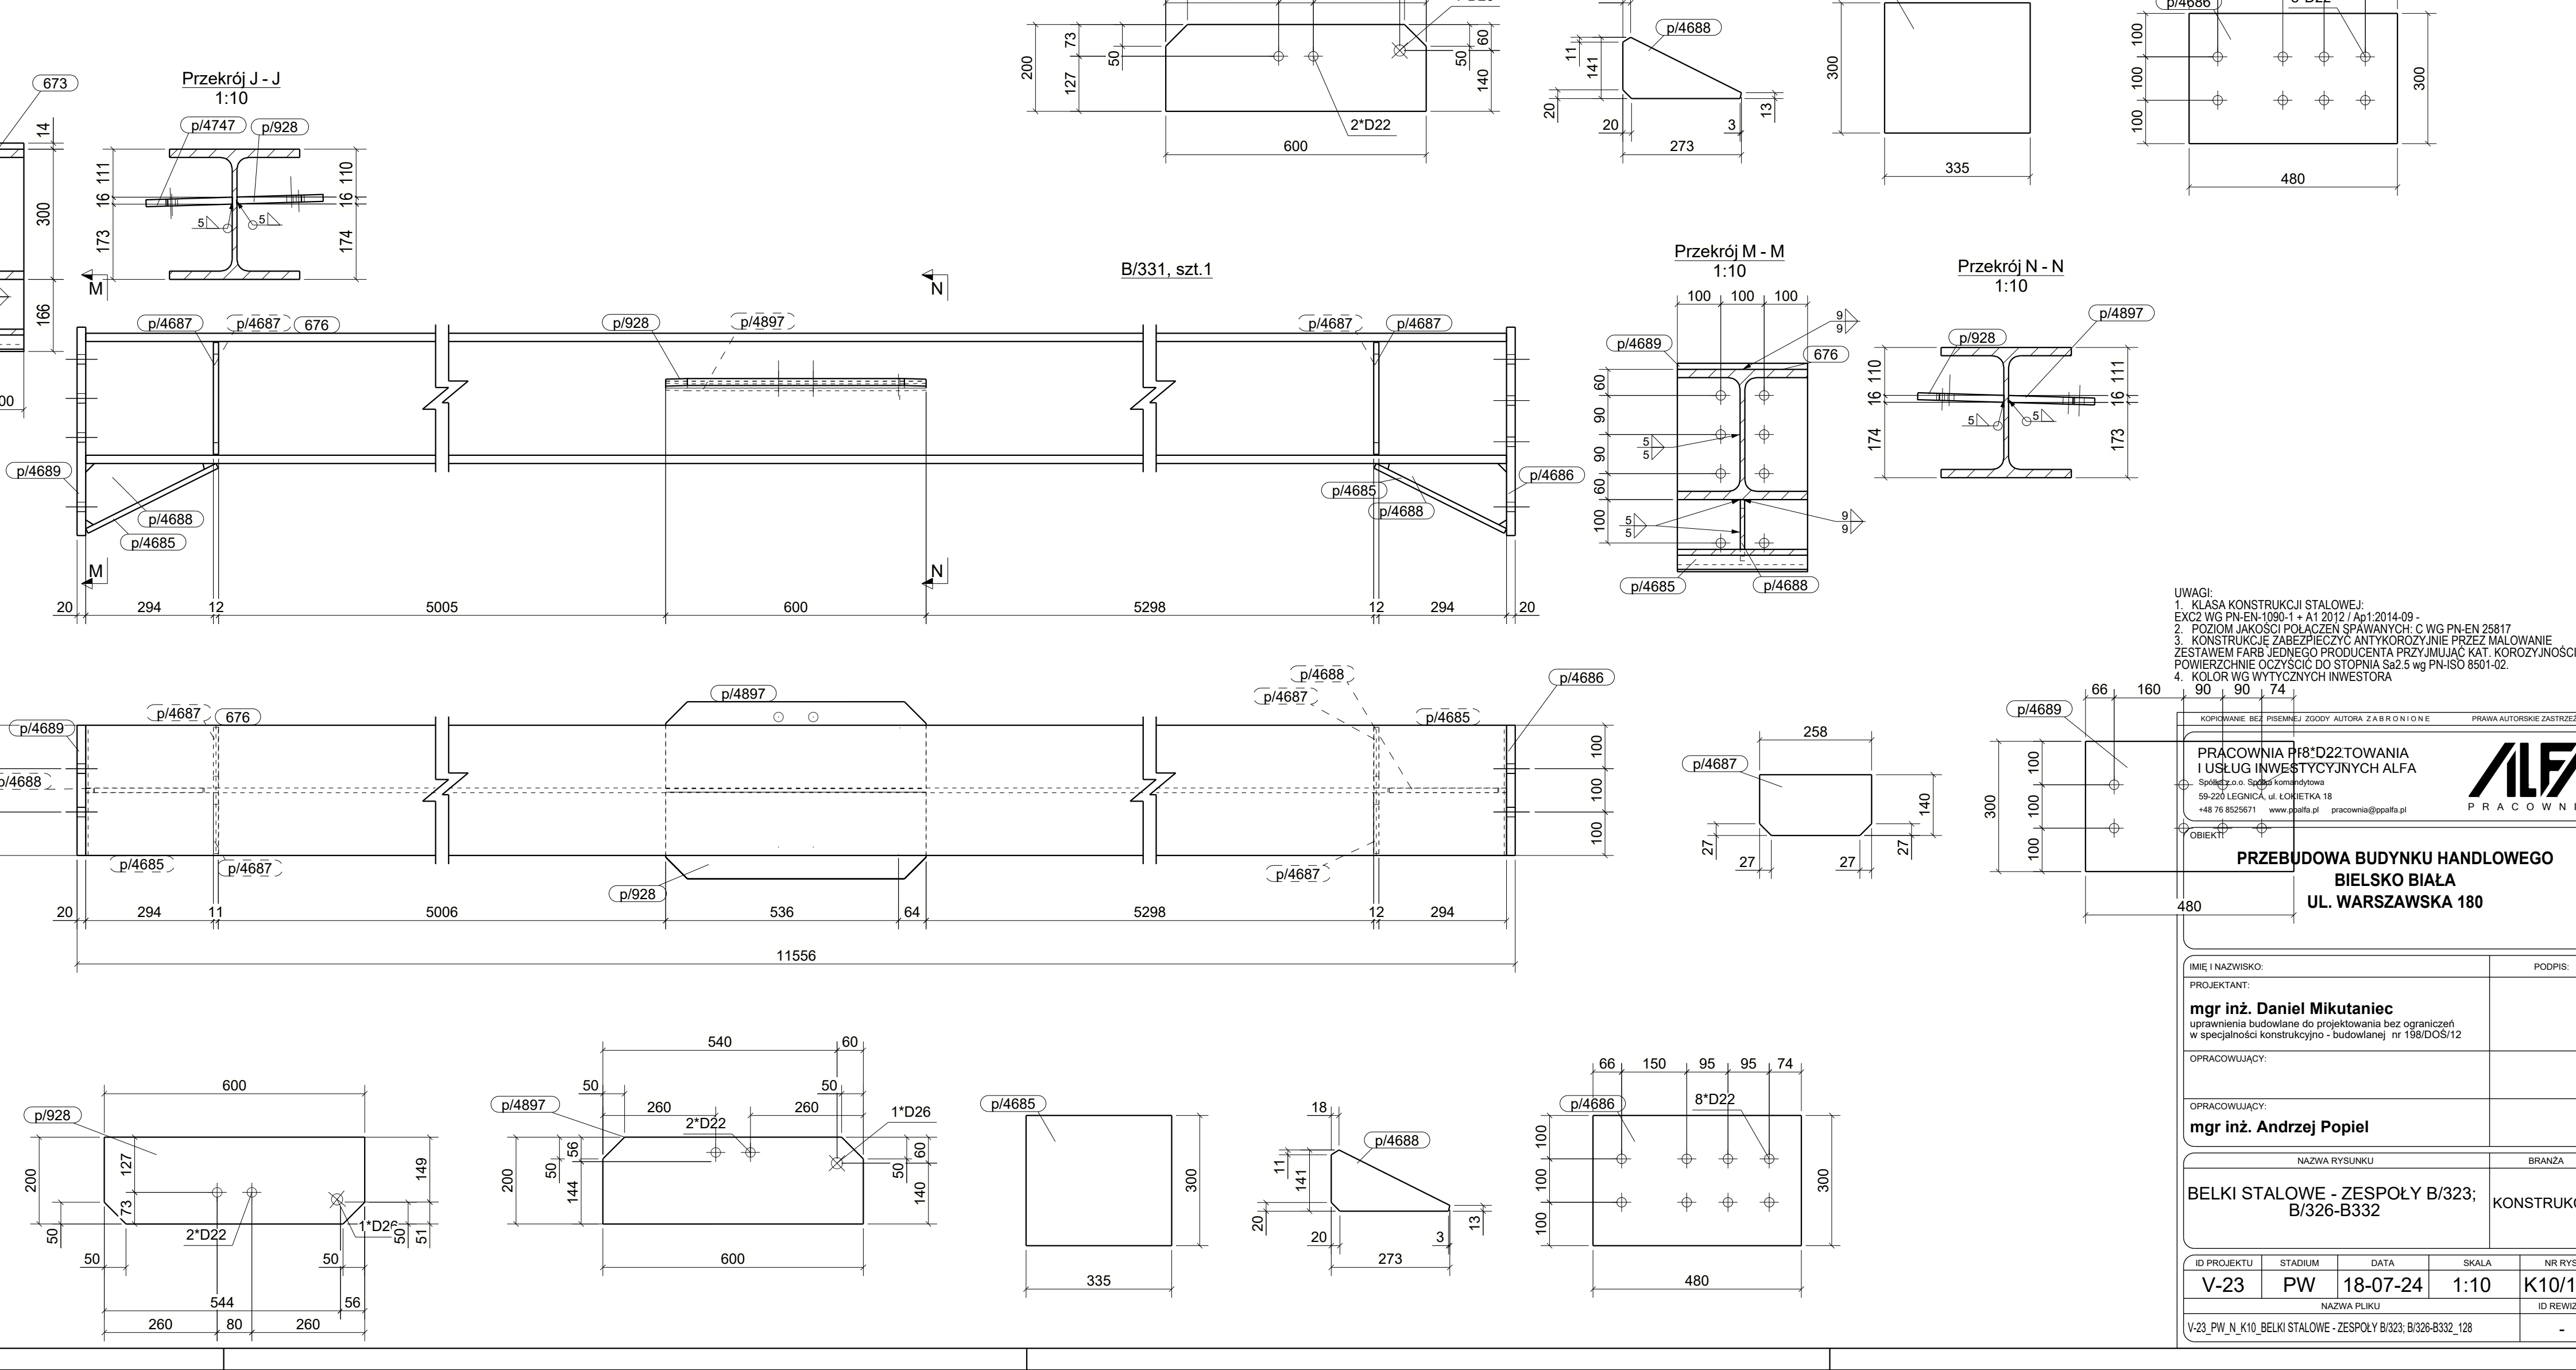
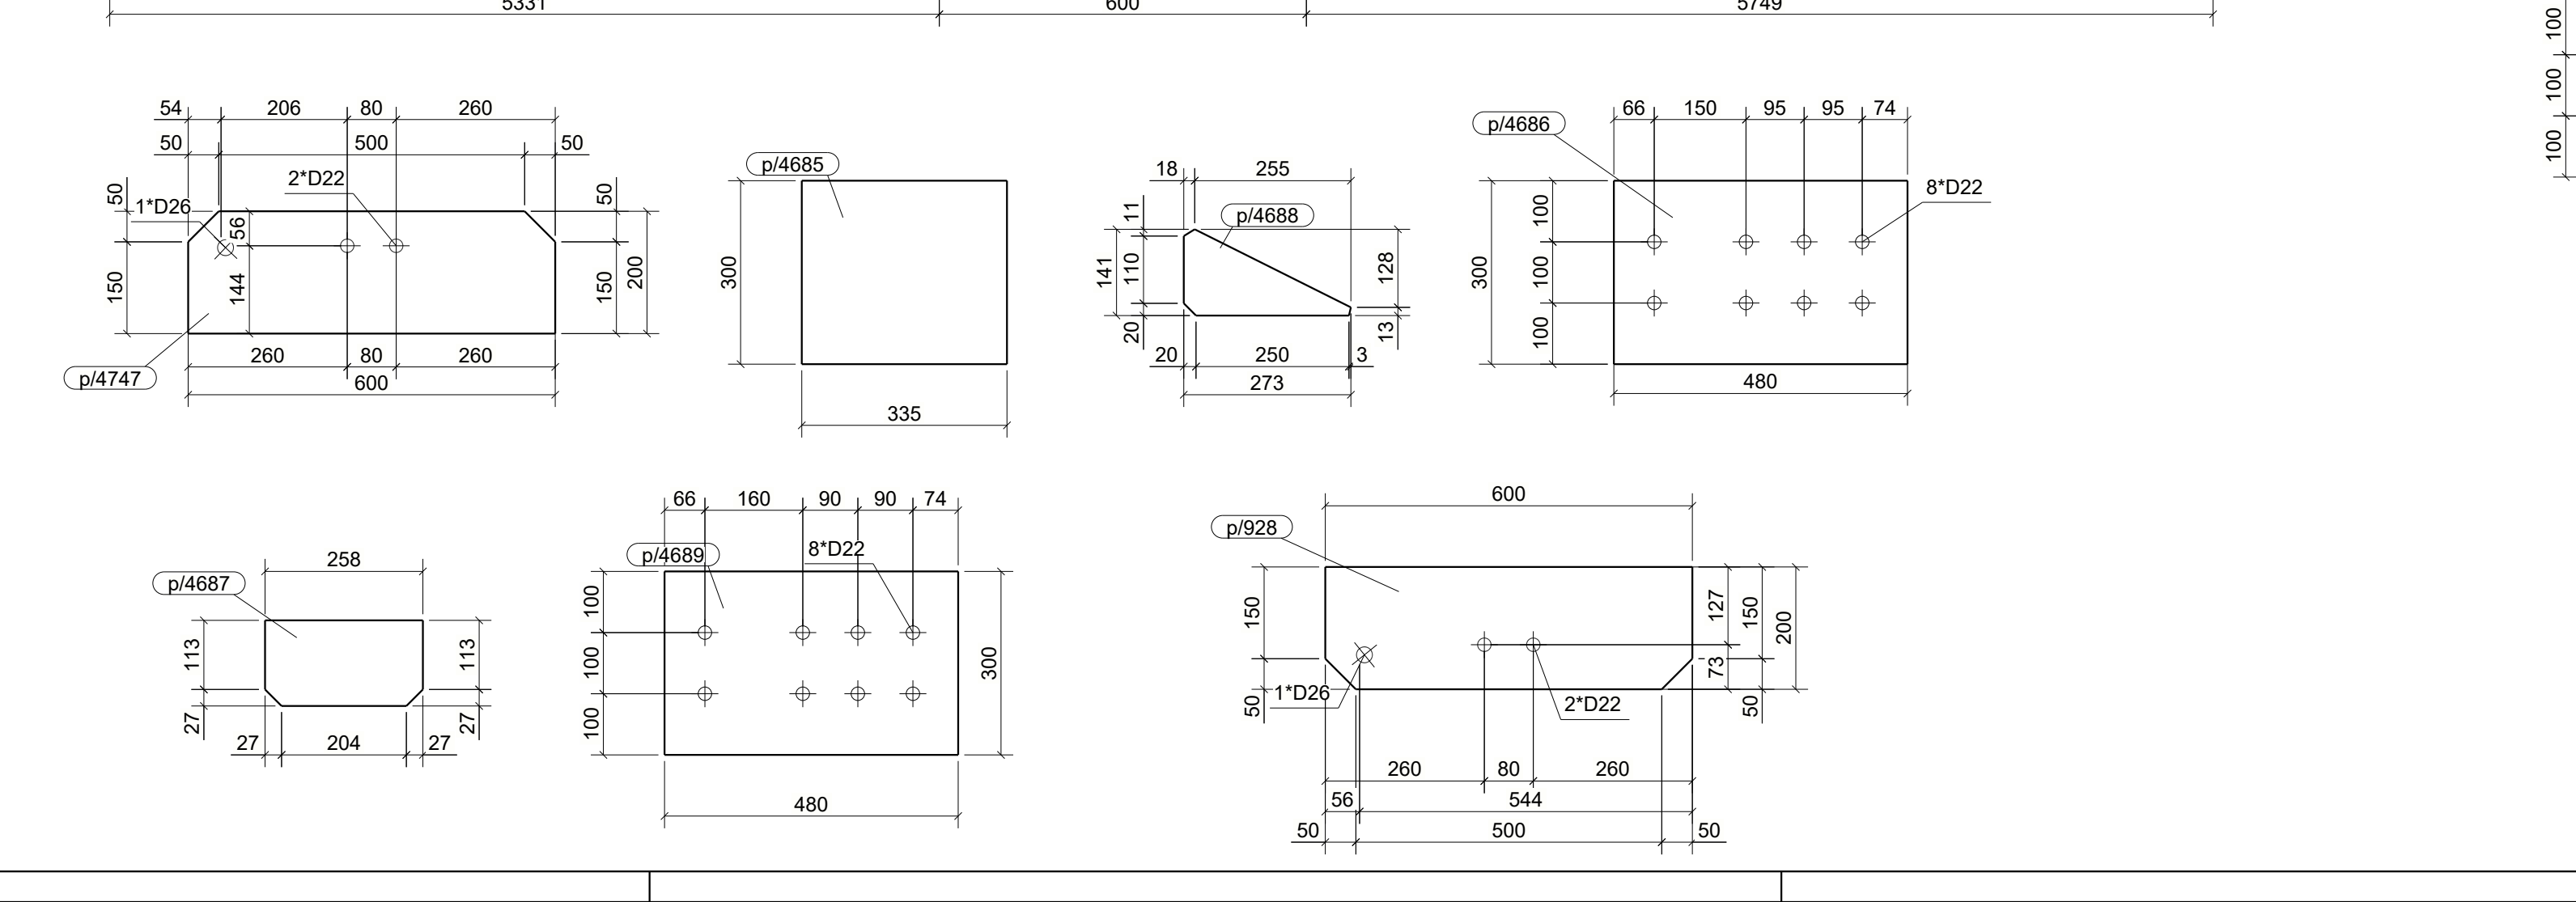
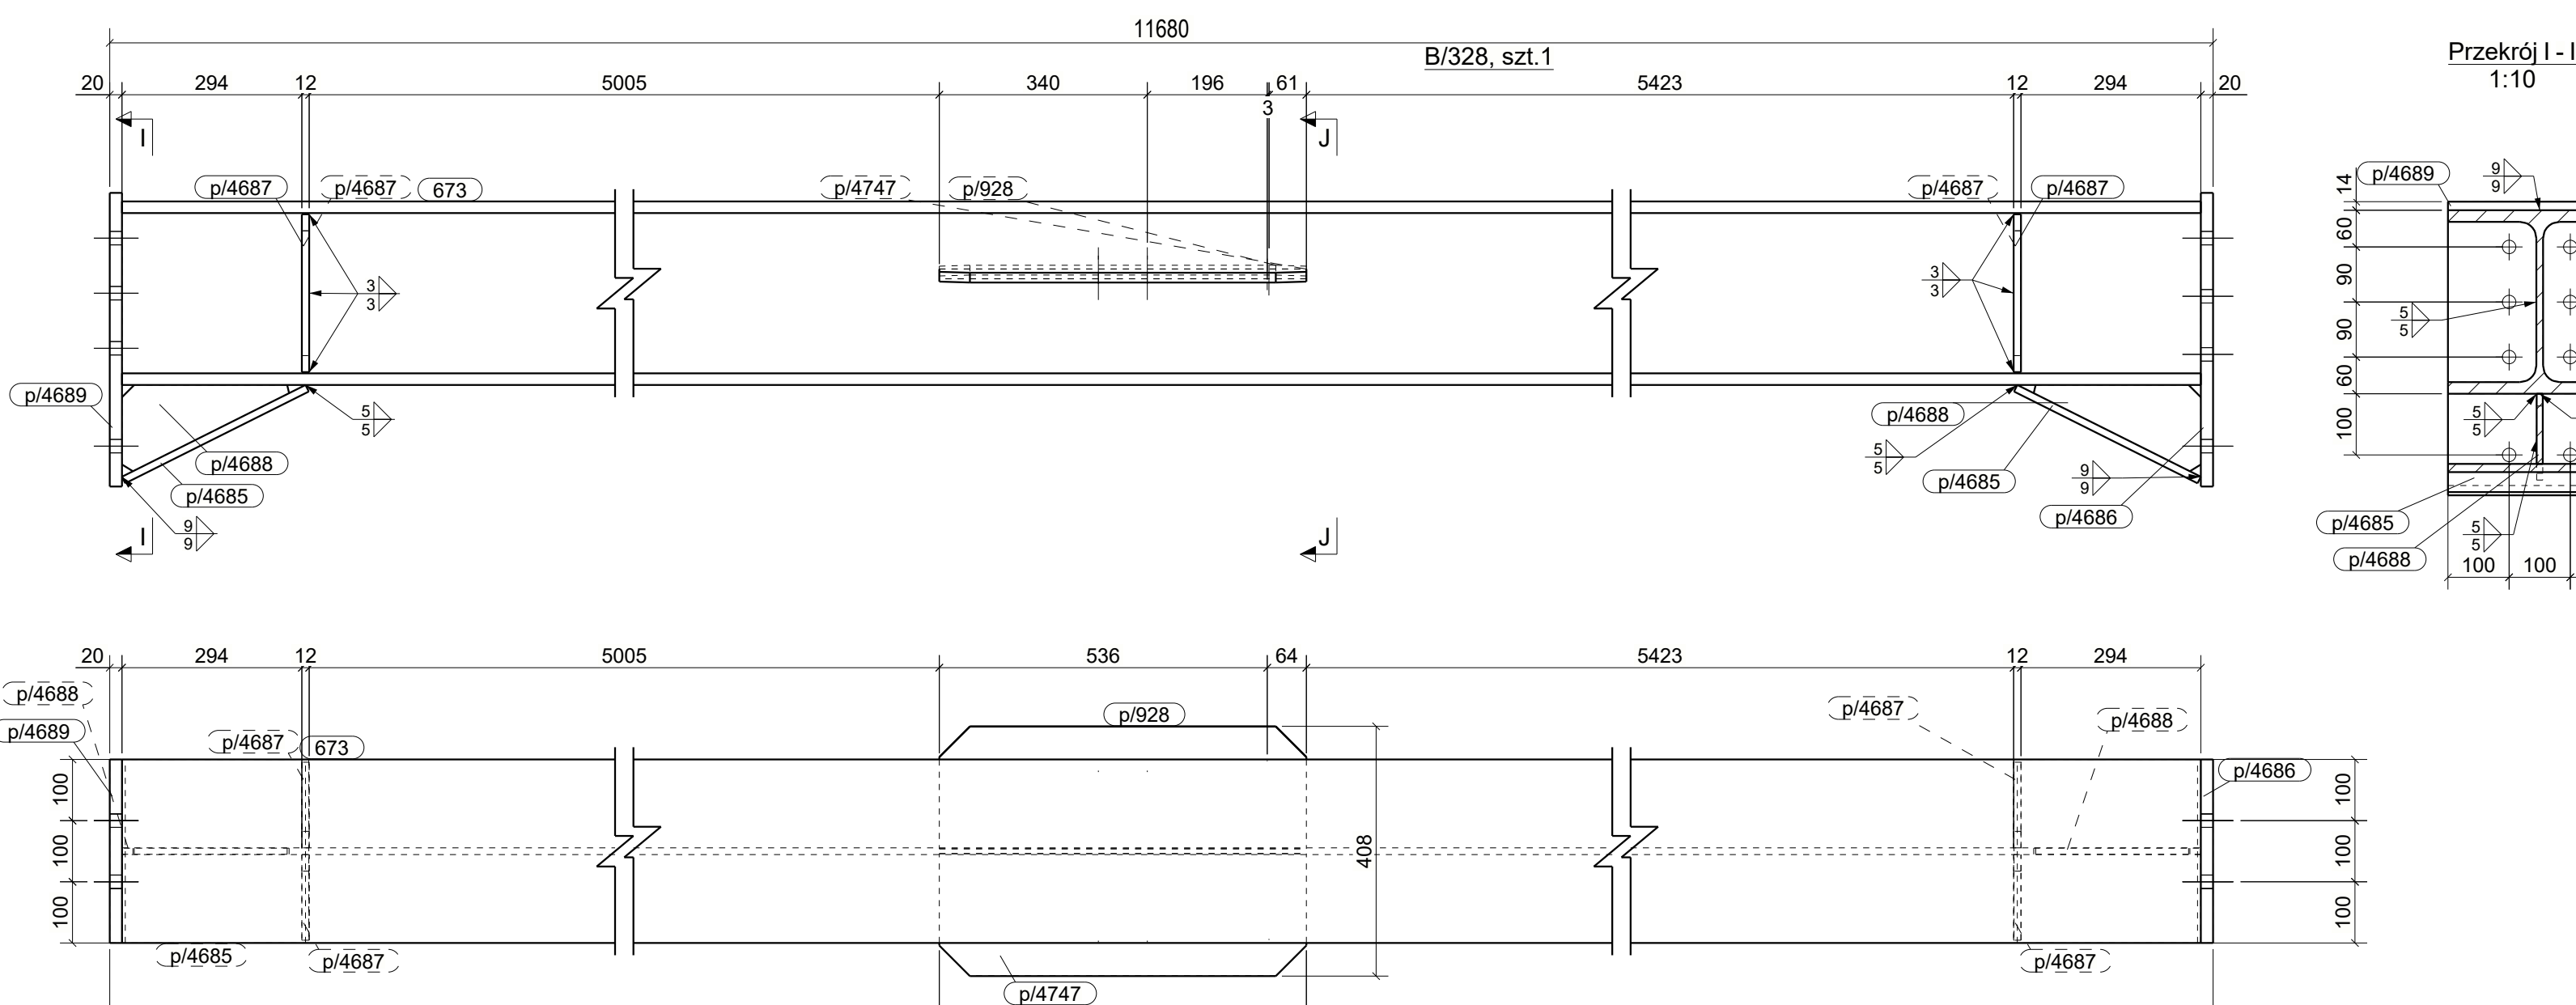


p4688	PL20*300	S235JR	1	480	22.6
p4687	PL12*140	S235JR	4	258	13.3
p4688	PL10*141.1	S235JR	2	273	3.4
p4689	PL20*300	S235JR	1	480	22.6

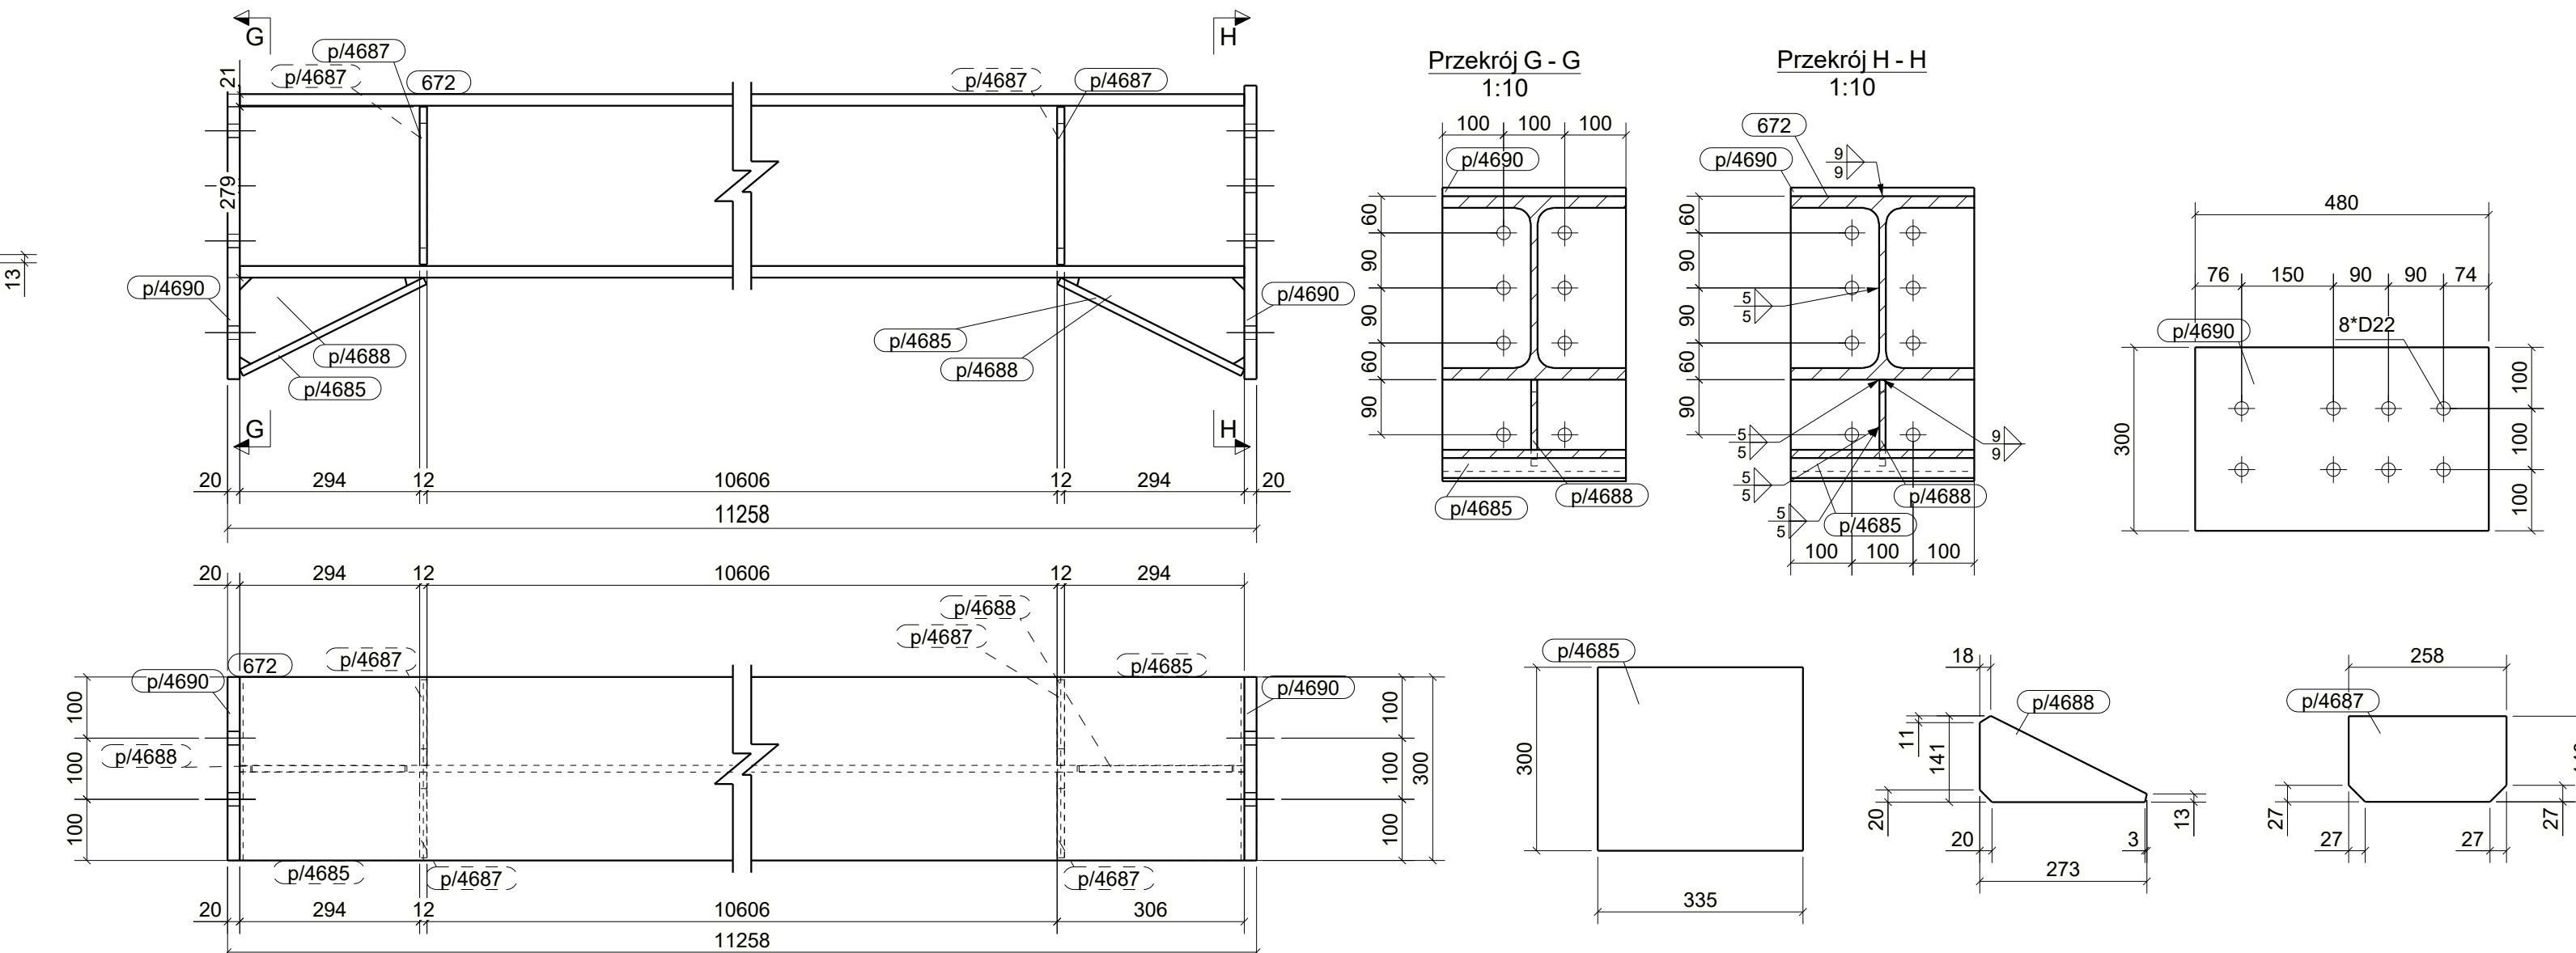

V-23	PW	18-07-24	1:10	K10/12
NAZWA PLIKU				ID REWIZ
V-23 PW N K10 BELKI STALOWE - ZESPOŁY B332; B338-B332 128				-